

THE CHESAPEAKE & OHIO RAILWAY COMPANY

PASSENGER STATION
AS BUILT CIRCA 1892
AT HINTON

SUMMERS COUNTY - - - WEST VIRGINIA

HINTON DIVISION - - - NEW RIVER SUBDIVISION

SCALE: 1/4" = 1 FOOT
CIRCA 1892

COPYRIGHT BY:
WILLIAM E. SIMONTON III

10/2010
©

SEE C & O DRAWINGS 1015, 1016, 1017, 1018, 1019 (1891)
PORTIONS OF ROOF OVERHANG CUT AWAY FOR CLARITY




RAILROAD NORTH ELEVATION



RAILROAD WEST ELEVATION



RAILROAD SOUTH ELEVATION

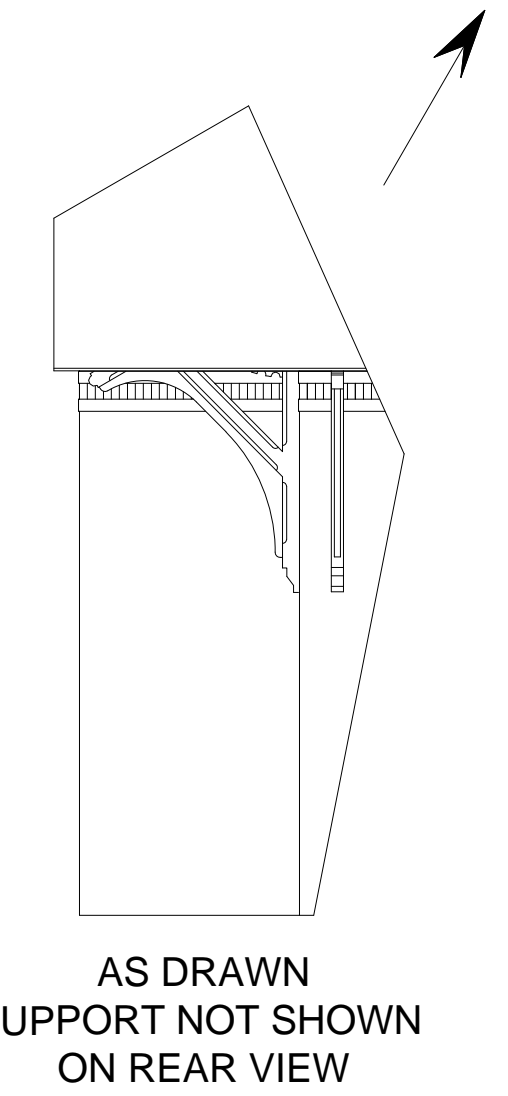

AS DRAWN
SUPPORT NOT SHOWN
ON REAR VIEW



RAILROAD EAST ELEVATION