


SUMMERS ST.

8TH AVE
 Old Wood Tank
 New 100000 Gal Steel Water Tank. Diam=24'
 42.5' Above Foundation

Pipe Storage Shed

ASH PIT
 Coal Tipples & Trestle

3'x3' Stone Box Culvert

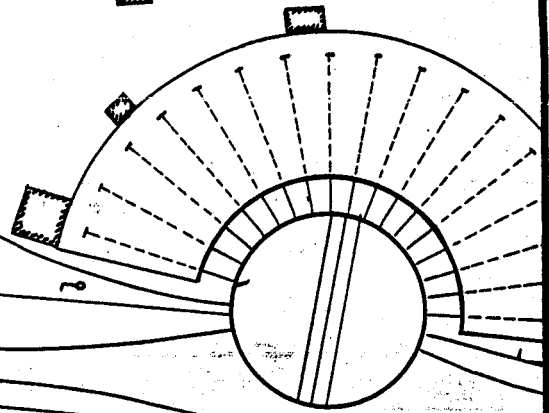


West to Chicago

W. B. M. Track
 E. B. M. Track

East to Fort Monroe

NEW RIVER

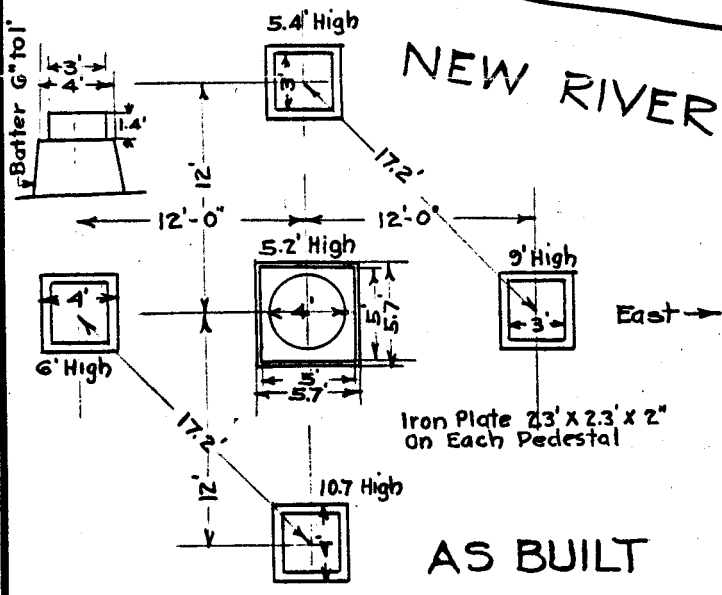

Iron Plate 23' x 23' x 2"
 On Each Pedestal

AS BUILT

FOUNDATION PLAN

THE CHESAPEAKE AND OHIO RAILWAY CO.
 Chief Engineers Office Richmond, Va.

100,000 GAL STEEL WATER
 TANK
 HINTON

Summers Co W. Virginia
 Hinton Division, New River District

Scale 1"=100'	Val. Section	Drawing No.
June 27, 1921	V-11	X-2923
Drawn by GGL		